



3012 Huron Street
Suite 100
Denver, Colorado 80202
phone 303.861.5704

COLORADO MOUNTAIN COLLEGE

107 DENISON PLACER ROAD
BRECKENRIDGE, CO

RECORD DOCUMENTS

These Record Documents have been prepared based on information (marked-up prints, drawings and other data) provided to the Architect by others. The Architect has not verified the accuracy and/or completeness of this information and shall not be responsible for the errors or omissions that may be incorporated as a result of erroneous information provided by others. These documents are for the Owner's convenience and cannot be used without written permission.

7/24/09

PROJ. NO. 56084.00

DRAWN: SC

CHECKED: DM

DATE: 7.24.09

REVISIONS:


© OZ ARCHITECTURE

RECORD DOCUMENTS

SHEET TITLE:
FINISH PLAN -
FIRST FLOOR

SCALE: AS NOTED
SHEET NUMBER:

A8.1

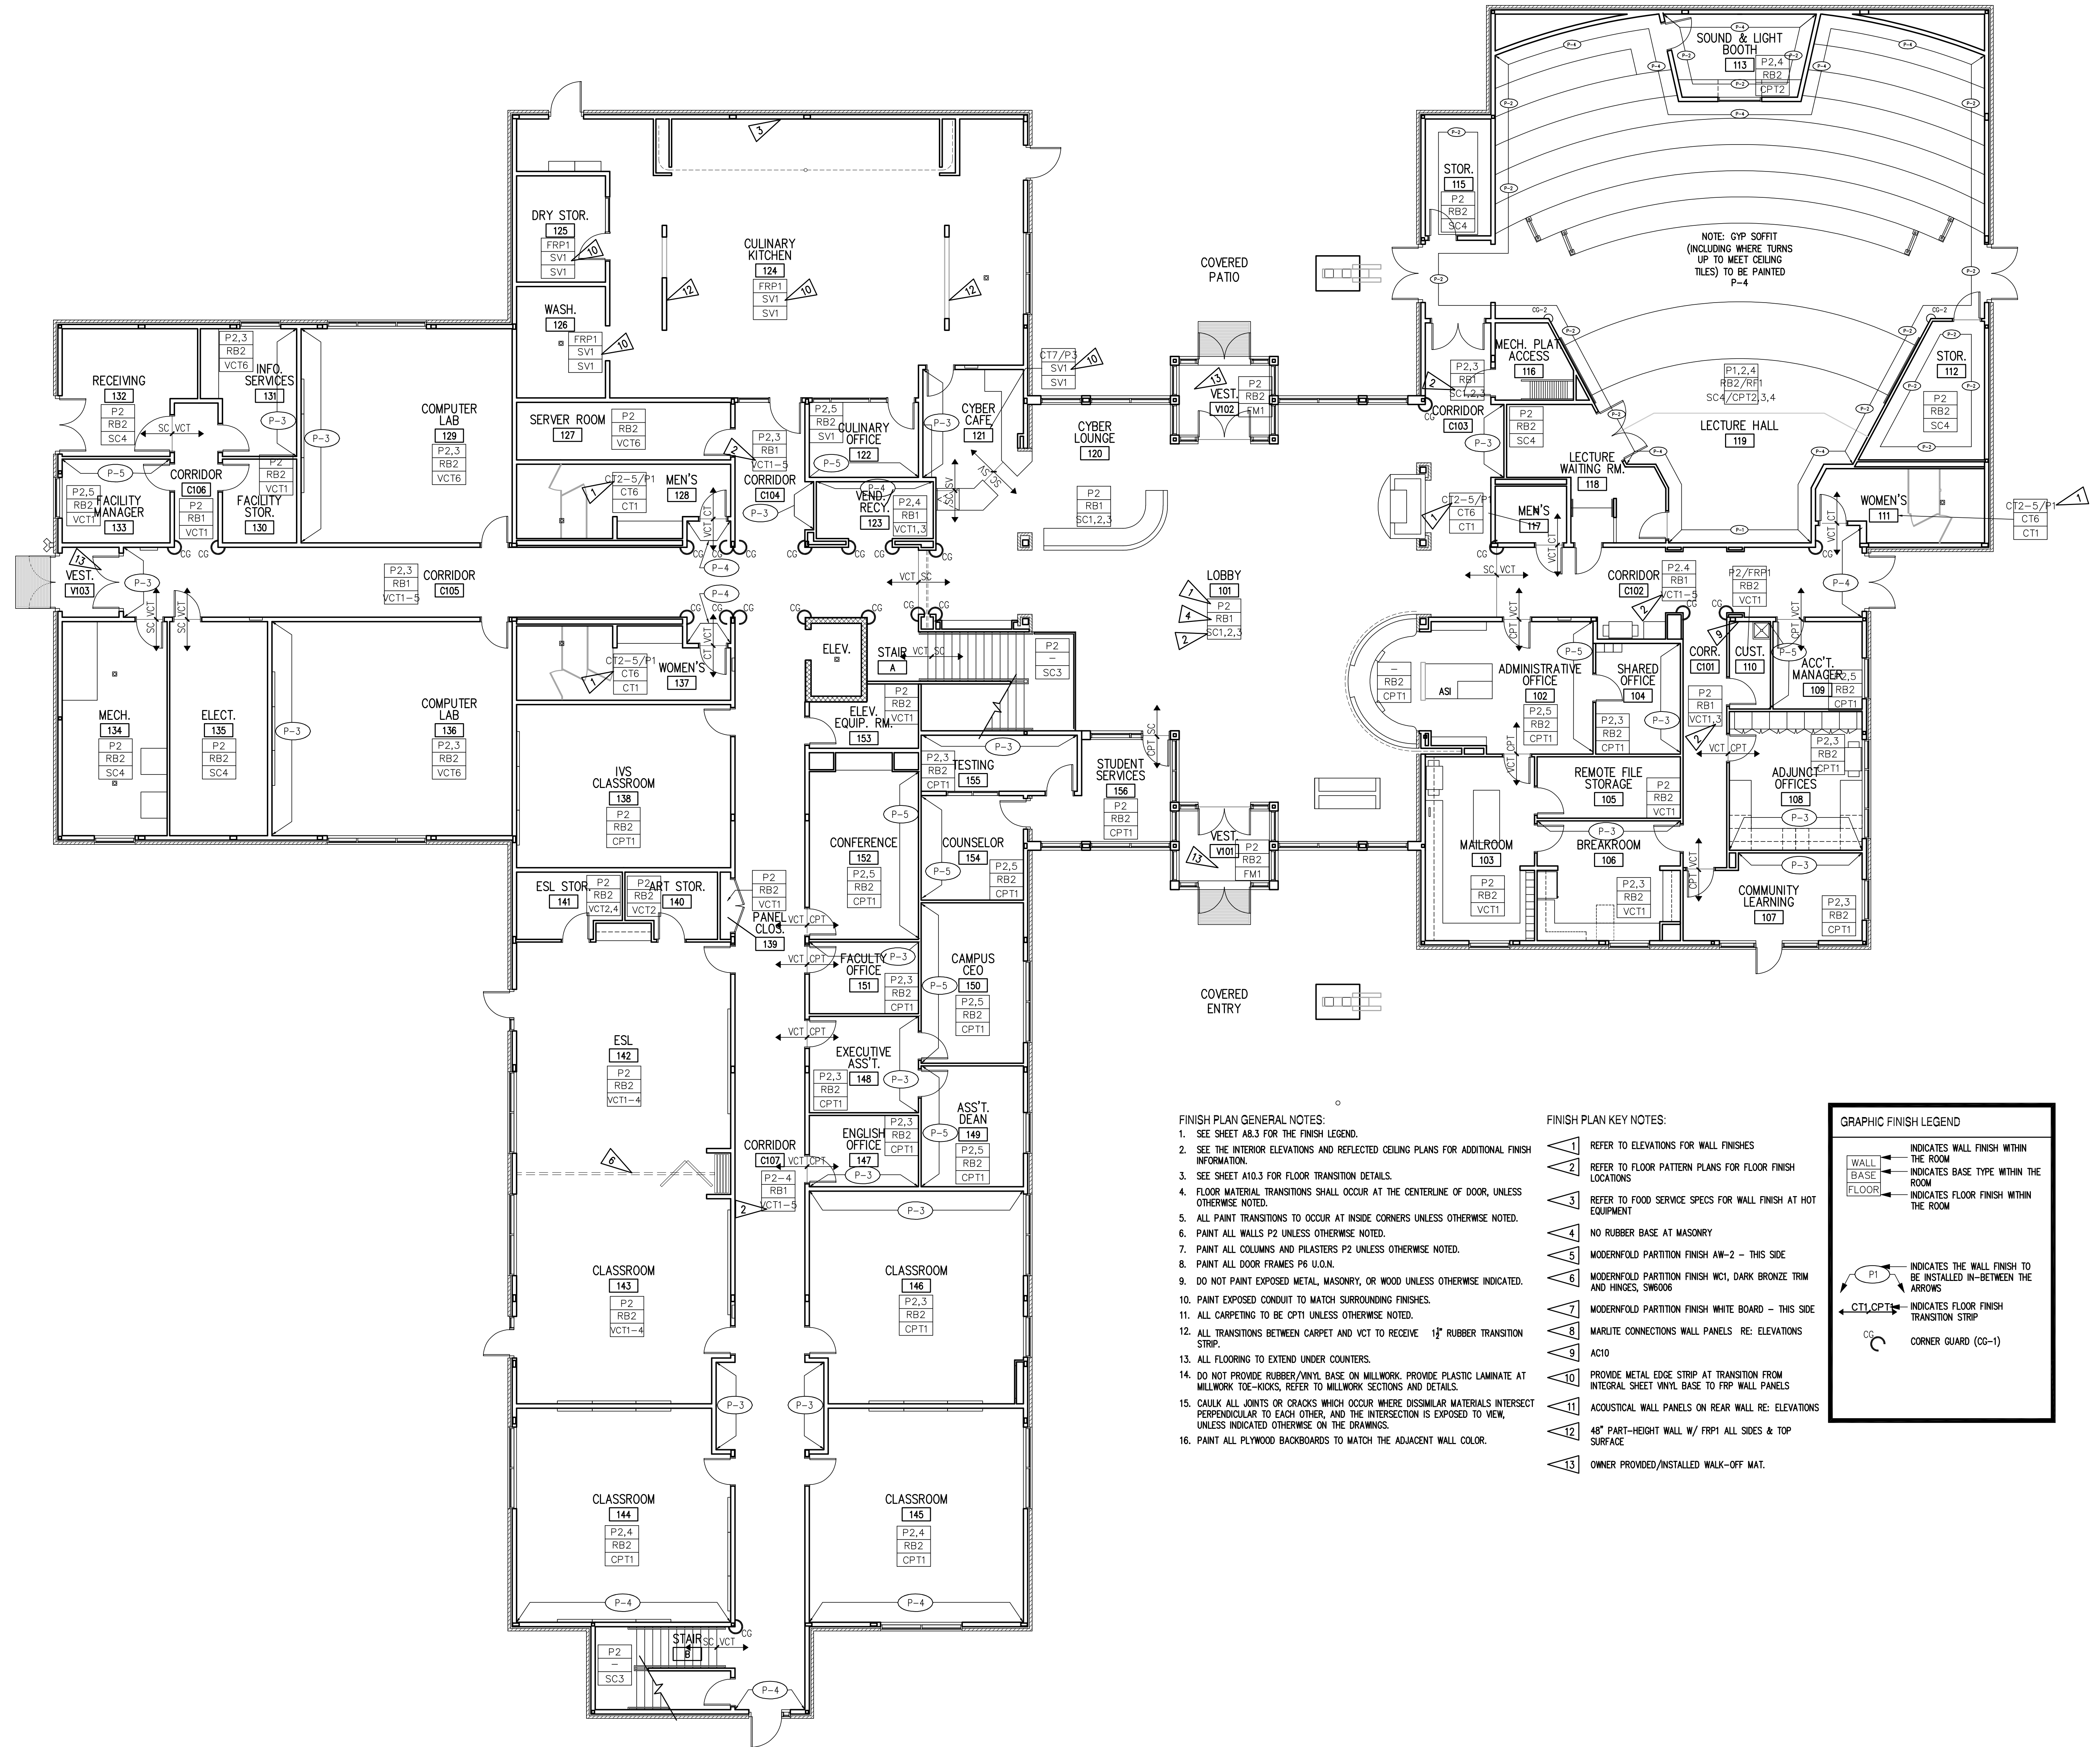

1 FIRST FLOOR FINISH PLAN

SCALE: 1/8" = 1'-0"





3012 Huron Street
Suite 100
Denver, Colorado 80202
phone 303.861.5704

COLORADO MOUNTAIN COLLEGE

107 DENISON PLACER ROAD
BRECKENRIDGE, CO

RECORD DOCUMENTS

These Record Documents have been prepared based on information (marked-up prints, drawings and other data) provided to the Architect by others. The Architect has not verified the accuracy and/or completeness of this information and shall not be responsible for the errors or omissions that may be incorporated as a result of erroneous information provided by others. These documents are for the Owner's convenience and cannot be used without written permission.

7/24/09

PROJ. NO. 56084.00

DRAWN: SC

CHECKED: DM

DATE: 7.24.09

REVISIONS:


© OZ ARCHITECTURE

RECORD DOCUMENTS

SHEET TITLE:
FINISH PLAN -
SECOND FLOOR

SCALE: AS NOTED
SHEET NUMBER:

A8.2

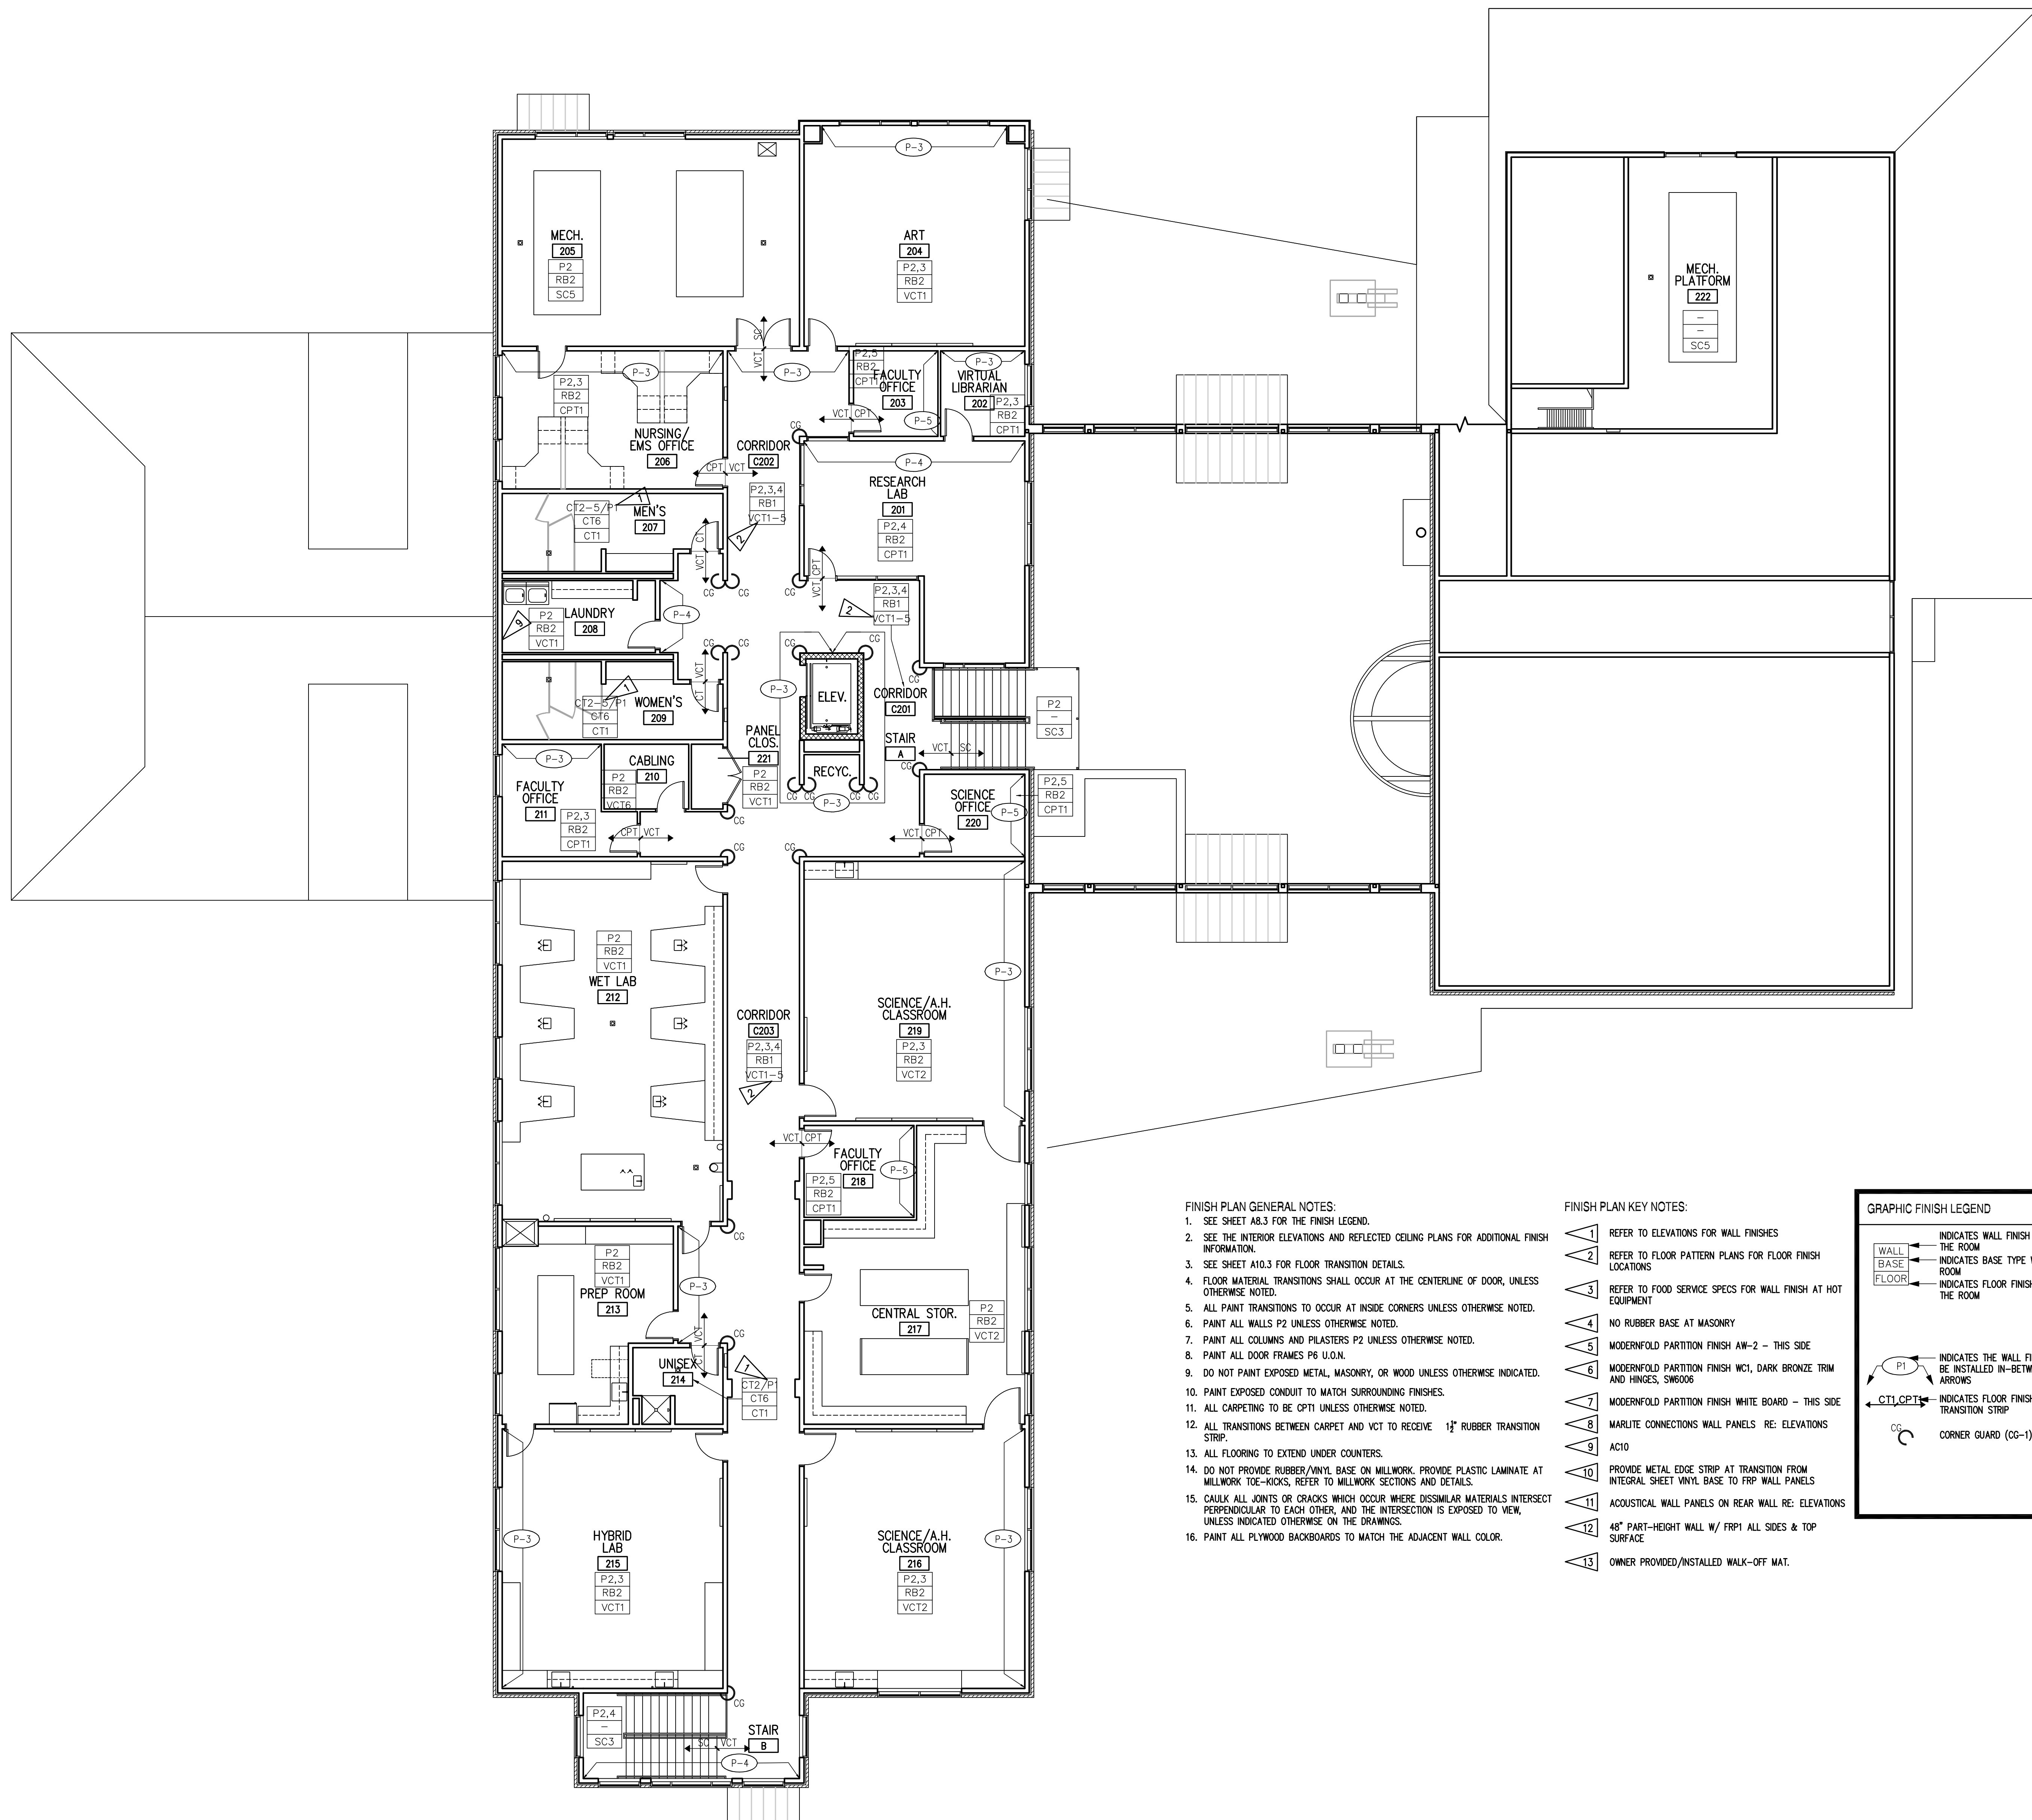


FINISH PLAN GENERAL NOTES:

1. SEE SHEET A8.3 FOR THE FINISH LEGEND.
2. SEE THE INTERIOR ELEVATIONS AND REFLECTED CEILING PLANS FOR ADDITIONAL FINISH INFORMATION.
3. SEE SHEET A10.3 FOR FLOOR TRANSITION DETAILS.
4. FLOOR MATERIAL TRANSITIONS SHALL OCCUR AT THE CENTERLINE OF DOOR, UNLESS OTHERWISE NOTED.
5. ALL PAINT TRANSITIONS TO OCCUR AT INSIDE CORNERS UNLESS OTHERWISE NOTED.
6. PAINT ALL WALLS P2 UNLESS OTHERWISE NOTED.
7. PAINT ALL COLUMNS AND PLASTERS P2 UNLESS OTHERWISE NOTED.
8. PAINT ALL DOOR FRAMES P6 U.O.N.
9. DO NOT PAINT EXPOSED METAL, MASONRY, OR WOOD UNLESS OTHERWISE INDICATED.
10. PAINT EXPOSED CONDUIT TO MATCH SURROUNDING FINISHES.
11. ALL CARPETING TO BE CPT1 UNLESS OTHERWISE NOTED.
12. ALL TRANSITIONS BETWEEN CARPET AND VCT TO RECEIVE 1/2" RUBBER TRANSITION STRIP.
13. ALL FLOORING TO EXTEND UNDER COUNTERS.
14. DO NOT PROVIDE RUBBER/VINYL BASE ON MILLWORK. PROVIDE PLASTIC LAMINATE AT MILLWORK TOE-KICKS, REFER TO MILLWORK SECTIONS AND DETAILS.
15. CAULK ALL JOINTS OR CRACKS WHICH OCCUR WHERE DISSIMILAR MATERIALS INTERSECT PERPENDICULAR TO EACH OTHER, AND THE INTERSECTION IS EXPOSED TO VIEW, UNLESS INDICATED OTHERWISE ON THE DRAWINGS.
16. PAINT ALL PLYWOOD BACKBOARDS TO MATCH THE ADJACENT WALL COLOR.

FINISH PLAN KEY NOTES:

- 1 REFER TO ELEVATIONS FOR WALL FINISHES
- 2 REFER TO FLOOR PATTERN PLANS FOR FLOOR FINISH LOCATIONS
- 3 REFER TO FOOD SERVICE SPECS FOR WALL FINISH AT HOT EQUIPMENT
- 4 NO RUBBER BASE AT MASONRY
- 5 MODERNFOLD PARTITION FINISH AW-2 - THIS SIDE
- 6 MODERNFOLD PARTITION FINISH WC1, DARK BRONZE TRIM AND HINGES, SW9006
- 7 MODERNFOLD PARTITION FINISH WHITE BOARD - THIS SIDE
- 8 MARLITE CONNECTIONS WALL PANELS RE: ELEVATIONS
- 9 AC10
- 10 PROVIDE METAL EDGE STRIP AT TRANSITION FROM INTEGRAL SHEET VINYL BASE TO FRP WALL PANELS
- 11 ACOUSTICAL WALL PANELS ON REAR WALL RE: ELEVATIONS
- 12 48" PART-HEIGHT WALL W/ FRP1 ALL SIDES & TOP SURFACE
- 13 OWNER PROVIDED/INSTALLED WALK-OFF MAT.

GRAPHIC FINISH LEGEND

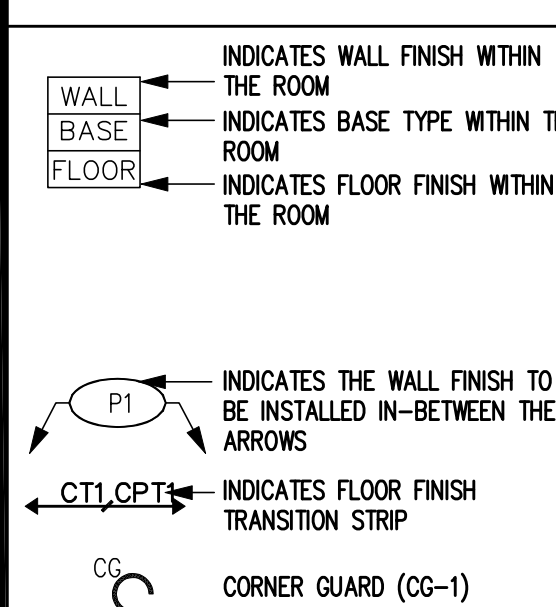

1 SECOND FLOOR FINISH PLAN

SCALE: 1/8" = 1'-0"

